City of Worthington
BOARD OF ZONING APPEALS APPLICATION

Meetings – First Thursday of Every Month

Case #	BZA 25-15
Date Received	6-1-15
Fee	$25.00 pd
Meeting Date	7-2-15
Filing Deadline	
Receipt #	60237

1. **Property Location** 198 Halligan Ave.
2. **Present/Proposed Use** family home
3. **Zoning District** R-10-N
4. **Applicant** Fran Welsh

   Address 198 Halligan Ave

   Phone Number(s) 614.885.2765 (h) 614.324.2116 (w)
5. **Property Owner** Fran Welsh

   Address 198 Halligan Ave.

   Phone Number(s) 614.885.2765 (h) 614.324.2116 (w)
6. **Action Requested** (ie. type of variance) HVACR PERMIT 2015-0110
7. **Project Details:**

   a) **Description** air conditioning unit installed on side of house where it was when house was built

   b) **Expected Completion Date** Jan. 9, 2015

   c) **Approximate Cost** $1,000

PLEASE READ THE FOLLOWING STATEMENTAND SIGN YOUR NAME:

The information contained in this application and in all attachments is true and correct to the best of my knowledge. I further acknowledge that I have familiarized myself with all applicable sections of the Worthington Codified Ordinances and will comply with all applicable regulations.

Frances A. Welsh — 5-22-15

Applicant (Signature) — Date

Frances A. Welsh — 5-22-15

Property Owner (Signature) — Date

Abutting Property Owners List for
198 Halligan Ave

Carey & Judith Songailo	6838 Joslyn Pl.	Worthington, OH 43085
Marie Roberts	5632 Norcross Rd.	Columbus, OH 43229
Resident	199 Abbot Ave.	Worthington, OH 43085
Brian Iarocci & Shauna Chandler	207 Abbot Ave.	Worthington, OH 43085
Mark & Darcy Nadler	206 Halligan Ave.	Worthington, OH 43085
Kurt & Raeanna Wieland	203 Halligan Ave.	Worthington, OH 43085
Vicky & Katrice Backie	191 Halligan Ave.	Worthington, OH 43085
Patrick & Amy Hester	6818 Joslyn Pl.	Worthington, OH 43085

198 Halligan Ave.

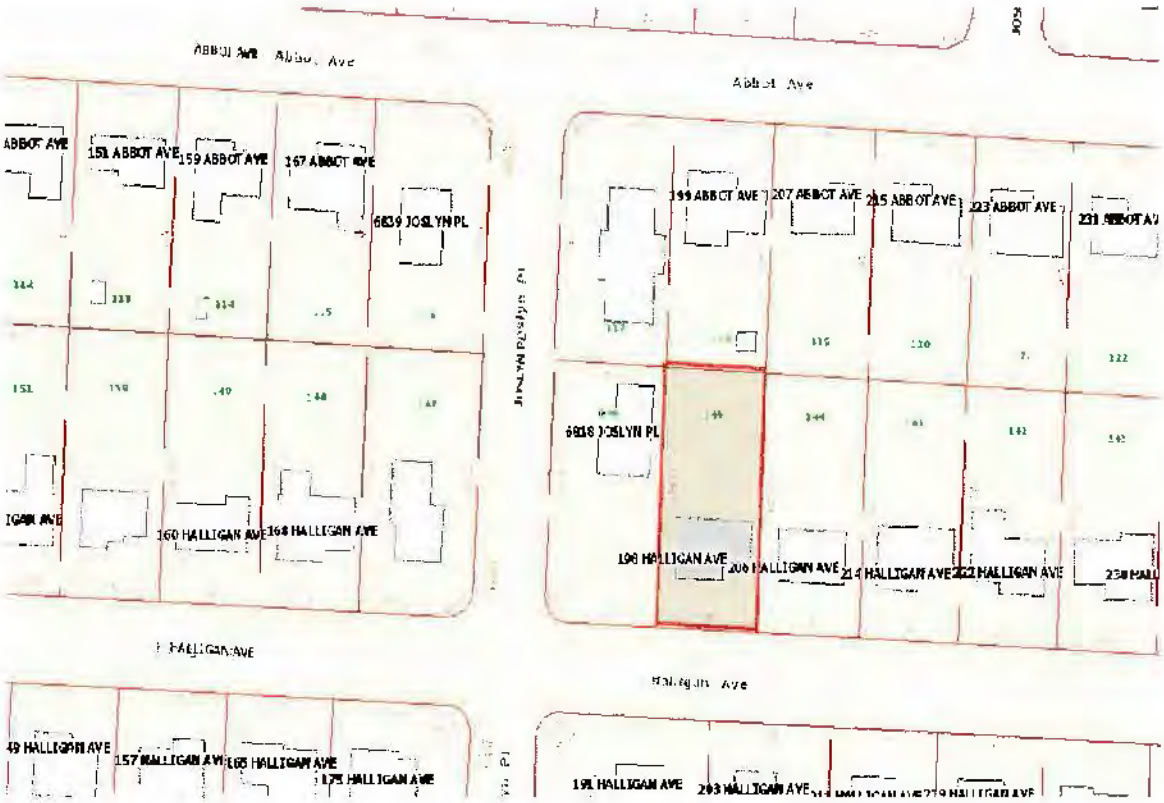

100-004227 04/05/2014

Clarence E. Mingo, II
Franklin County Auditor

MAP(GIS)

Generated on 01/28/15 at 01:02:10 PM

Parcel ID	Map Routing No	Card No	Location
100-004227-00	100-N234B -038-00	1	198 HALLIGAN AV

GIS

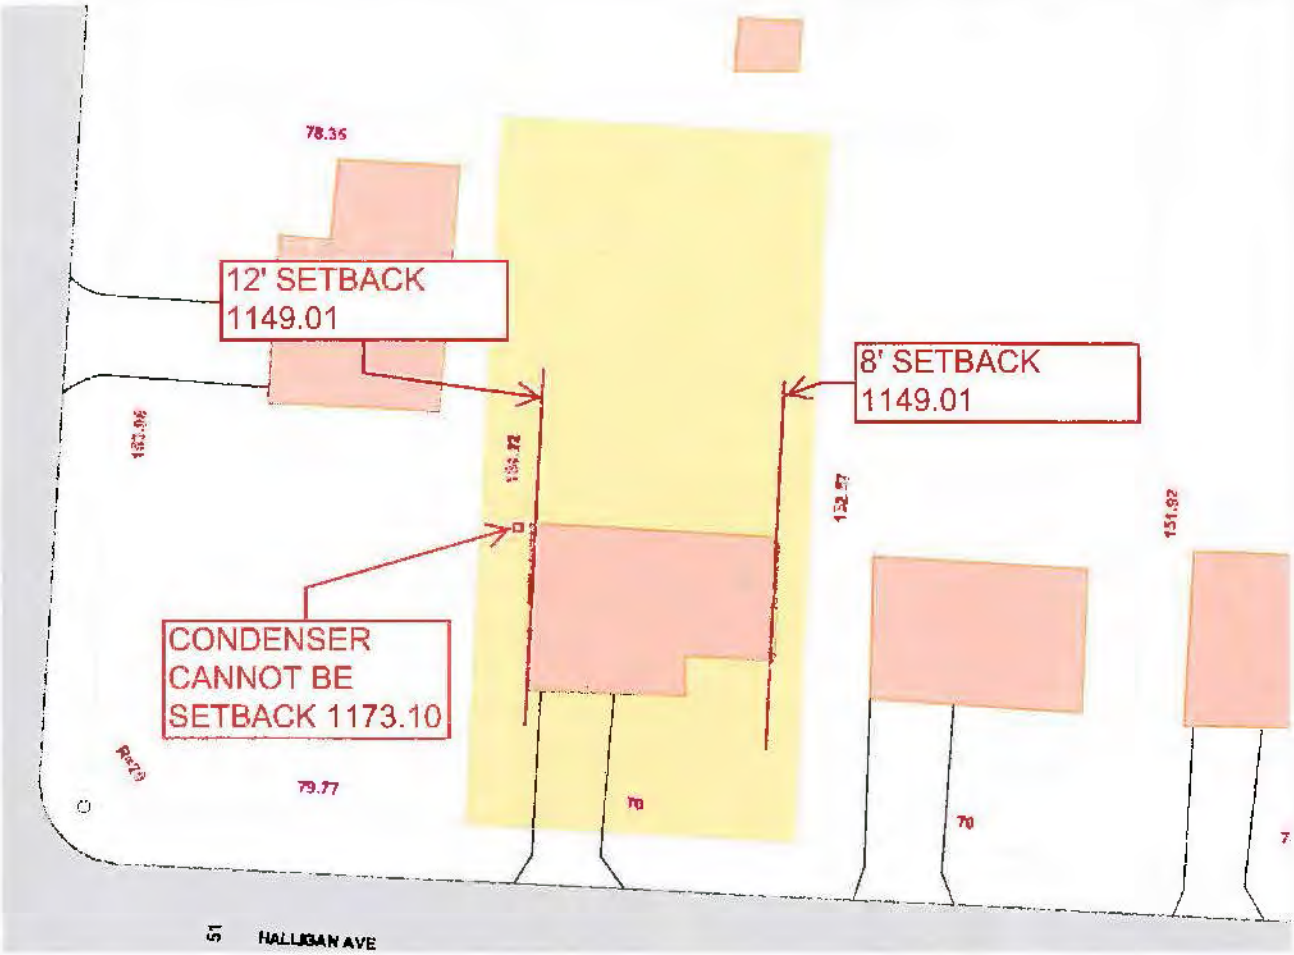

Disclaimer

This drawing is prepared for the real property inventory within this county. It is compiled from recorded deeds, survey plats, and other public records and data. Users of this drawing are notified that the public primary information source should be consulted for verification of the information contained on this drawing. The county and the mapping companies assume no legal responsibilities for the information contained on this drawing. Please notify the Franklin County GIS Division of any discrepancies.

The information on this web site is prepared for the real p ... are notified that the public primary information source should be consulted for verification of the information contained on this site. Th ... for the information contained on this site. Please notify the Franklin County ... epancies.

City of Worthington, Ohio
Reviewed for
Code Compliance

Application # 2015-0110(1)

☐ Approved
☐ Approved as Noted
☐ Partial/Phased Approval
(see attached plan approval letter)
☒ Not Approved

Don Phillips
Reviewed by

1/28/15
Date

CITY OF WORTHINGTON
BZA 25-15
DRAWING NO.

DATE 6-1-15