# City of Worthington

## ARCHITECTURAL REVIEW BOARD

Certificate of Appropriateness
Application

| | |
|---|---|
| Case # | AR 53-15 |
| Date Received | 6/26/15 |
| Fee | $5.00 pd |
| Meeting Date | 7/9/15 |
| Filing Deadline | |
| Receipt # | 60405 |

1. **Property Location** 581 Oxford St
2. **Present/Proposed Use** Residential
3. **Zoning District** _____
4. **Applicant** Sabine & Robert Holub
   **Address** 581 Oxford St.
   **Phone Number(s)** 516-501-4632
5. **Property Owner** Same
   **Address** _____
   **Phone Number(s)** _____
6. **Project Description** addition of deck "walkway" connecting back deck & existing garage breezeway
7. **Project Details:**
   a) **Design** see attached plan
   b) **Color** ~~to~~ decking material to match existing
   c) **Size** see plan
   d) **Approximate Cost** $5,000 **Expected Completion Date** 7/30/15

**PLEASE READ THE FOLLOWING STATEMENTAND SIGN YOUR NAME:**
The information contained in this application and in all attachments is true and correct to the best of my knowledge. I further acknowledge that I have familiarized myself with all applicable sections of the Worthington Codified Ordinances and will comply with all applicable regulations.

Robert Holub + Sabine S. Holub 6/25/15
Applicant (Signature) Date

Robert Holub + Sabine S. Holub 6/25/15
Property Owner (Signature) Date

Abutting Property Owners List for
581 Oxford St.

| | | |
|---|---|---|
| Corrine Meyer | 587 Oxford St. | Worthington, OH 43085 |
| Alexander & Deidre Serrano | 59 W. Short St. | Worthington, OH 43085 |
| Don & Lori Overmyer | 573 Oxford St. | Worthington, OH 43085 |
| Todd Bradham | 570 Evening St. | Worthington, OH 43085 |
| Barbara McFarland | 578 Evening St. | Worthington, OH 43085 |

# Application for ARB – Installation of Deck "walkway" 581 Oxford St.

The proposed design includes a deck "walkway" connecting an existing deck that was built in the summer of 2014 and a breezeway connecting a side door and the garage. The "walkway" will be constructed of the same material as the new deck. The walkway will be no higher than 8" above existing grade at any location of the walkway. Two step downs are included in the design. No railings are included. Please see attached pictures.

# 581 Oxford St.

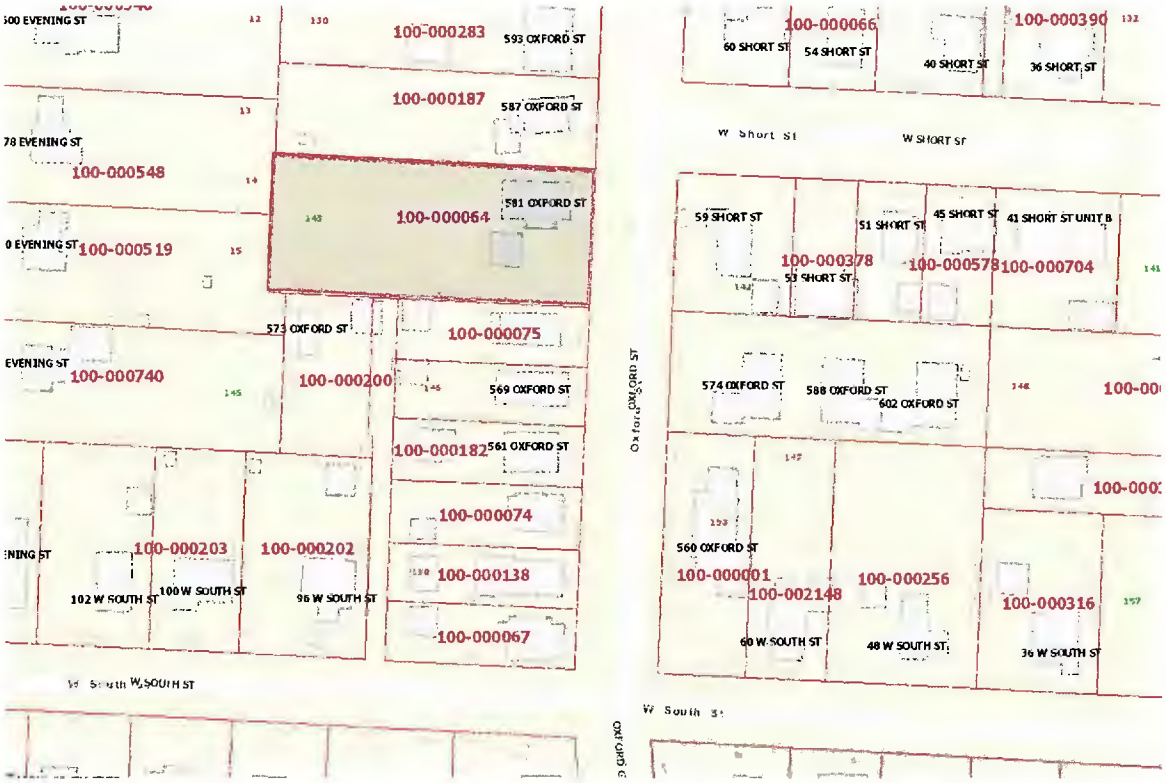

100-000064 04/10/2014

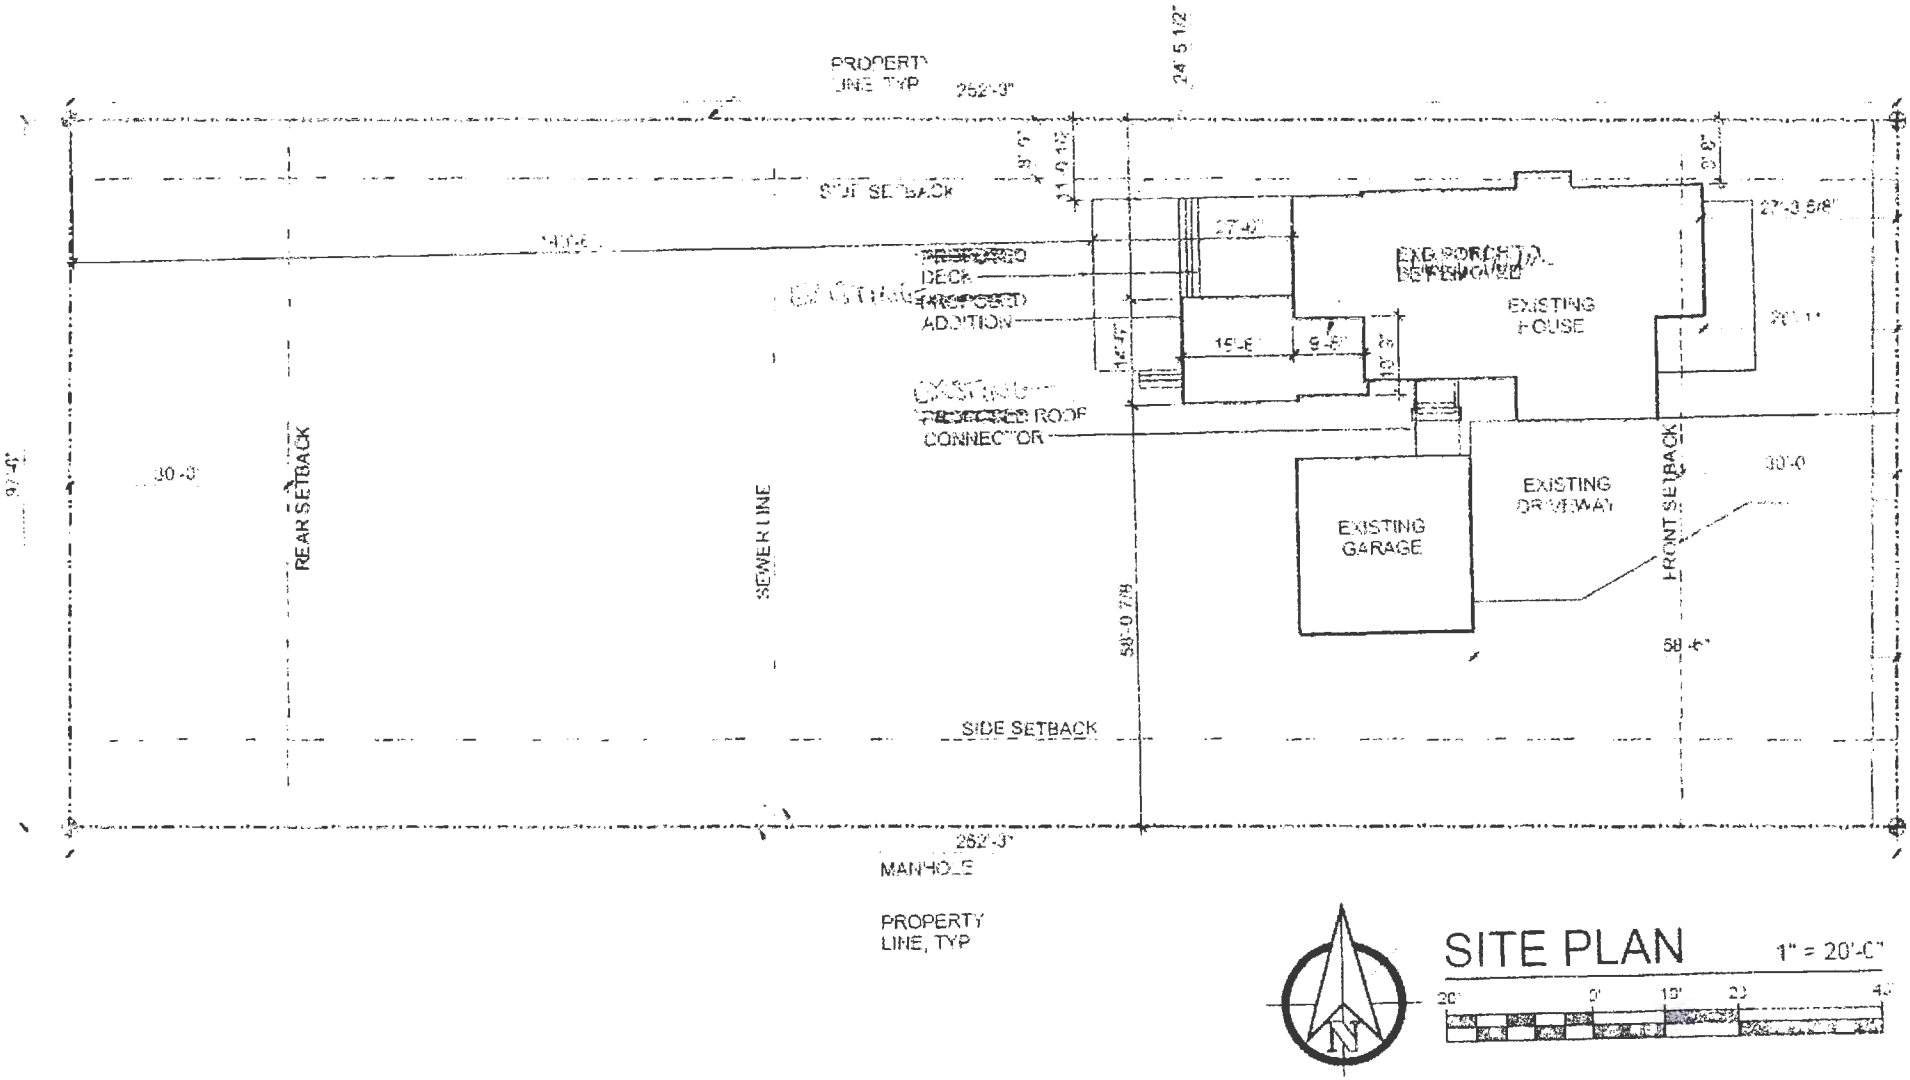


CITY OF WORTHINGTON
AR 53-15
DRAWING NO.

DATE 6-26-15

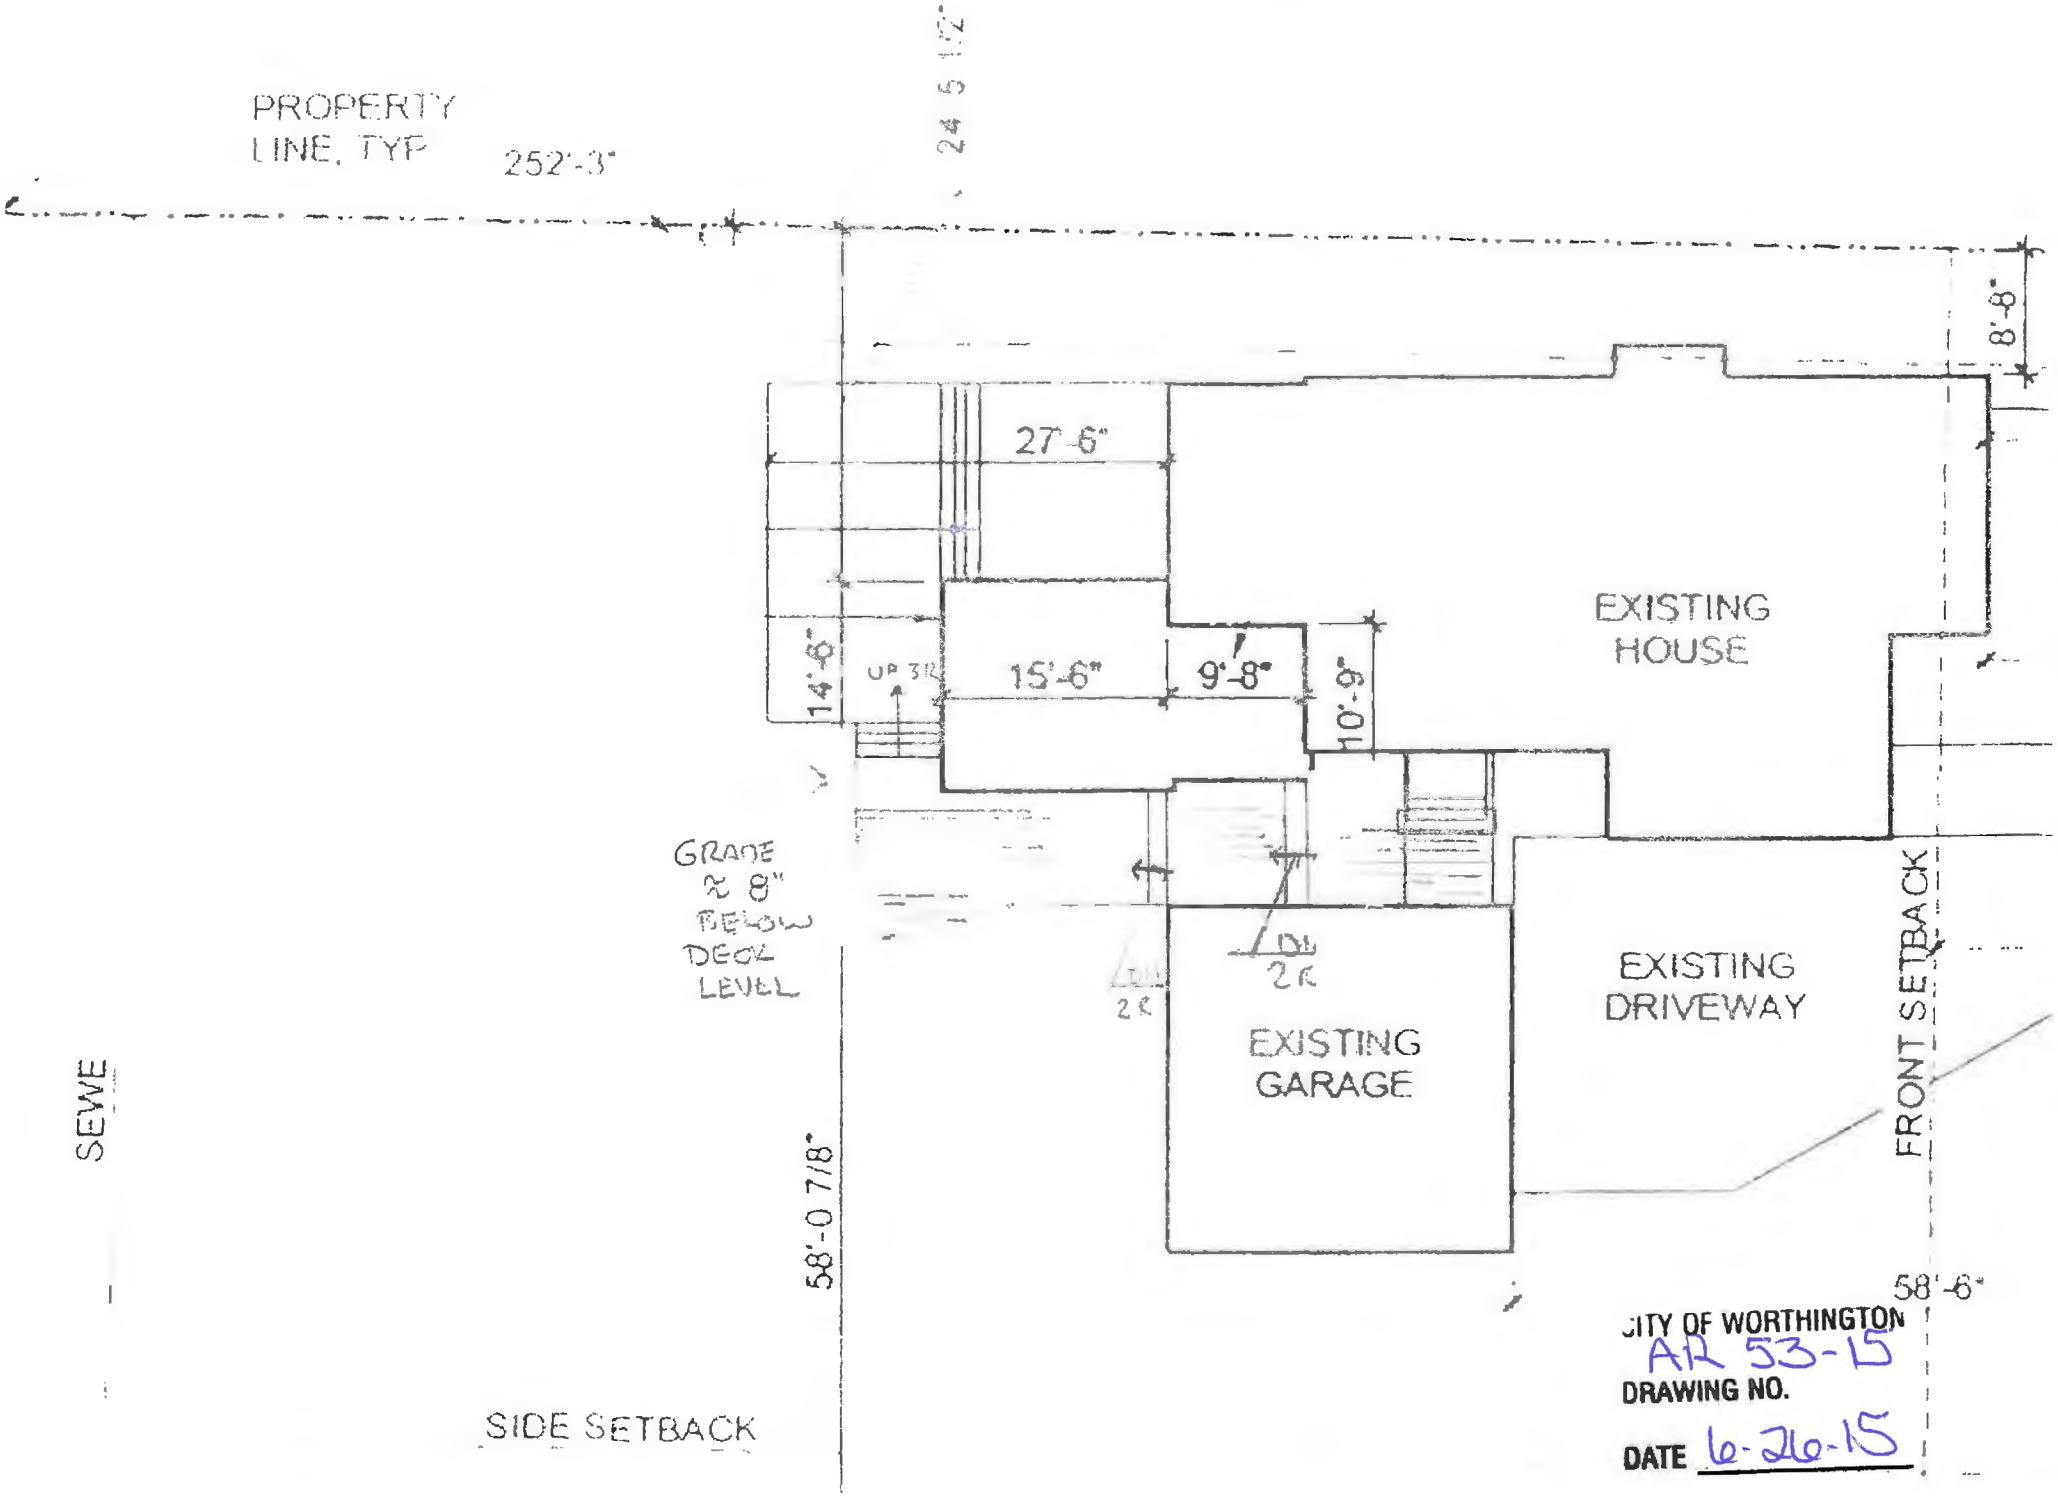


CITY OF WORTHINGTON
AR 53-15
DRAWING NO.
DATE 6-26-15

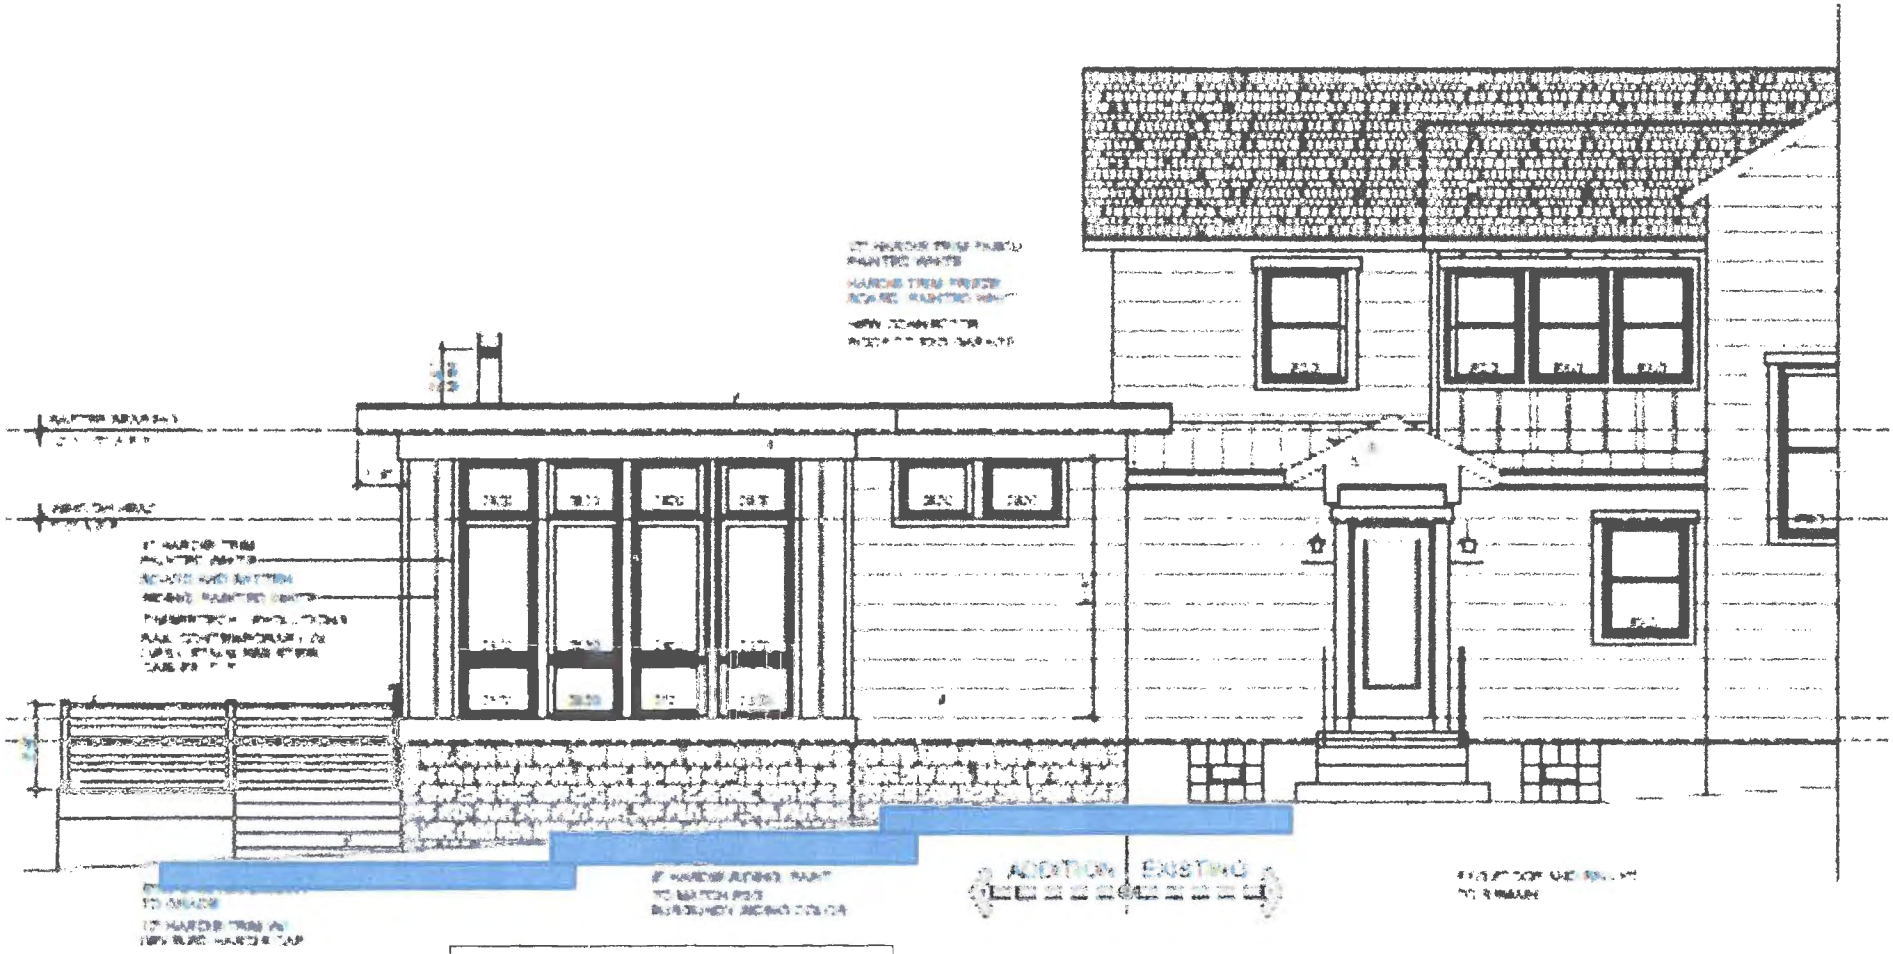


Proposed deck walkway elevation

CITY OF WORTHINGTON
AR 53-15
DRAWING NO.
DATE 6-26-25